


FLOOR 3

18,600 RSF

**75,000 RSF of Contiguous Space Available*

AS-BUILT

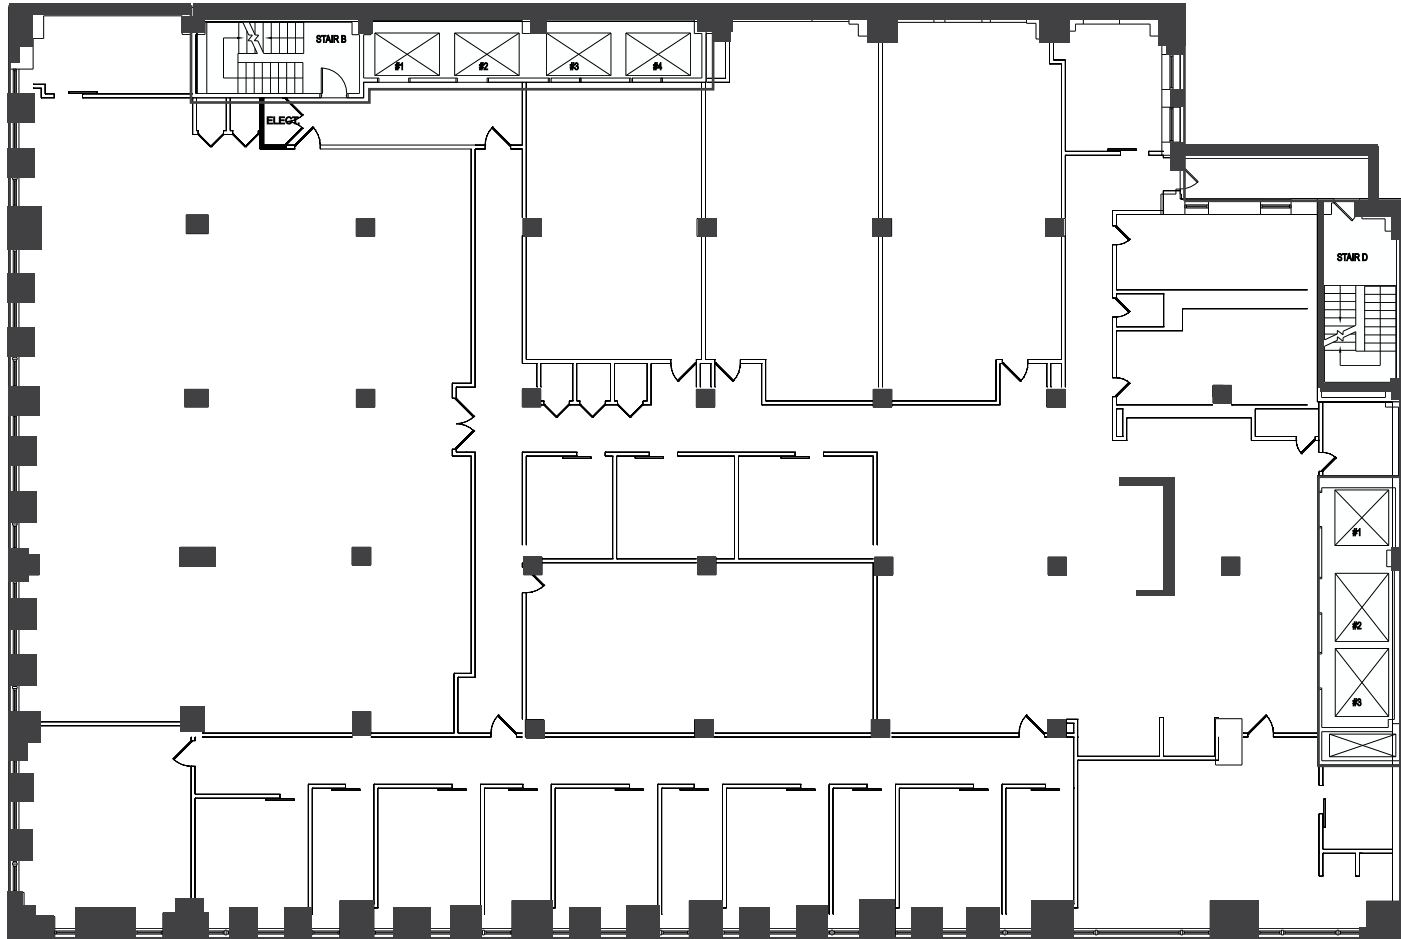


FLOOR 4

18,600 RSF

**75,000 RSF of Contiguous Space Available*

AS-BUILT

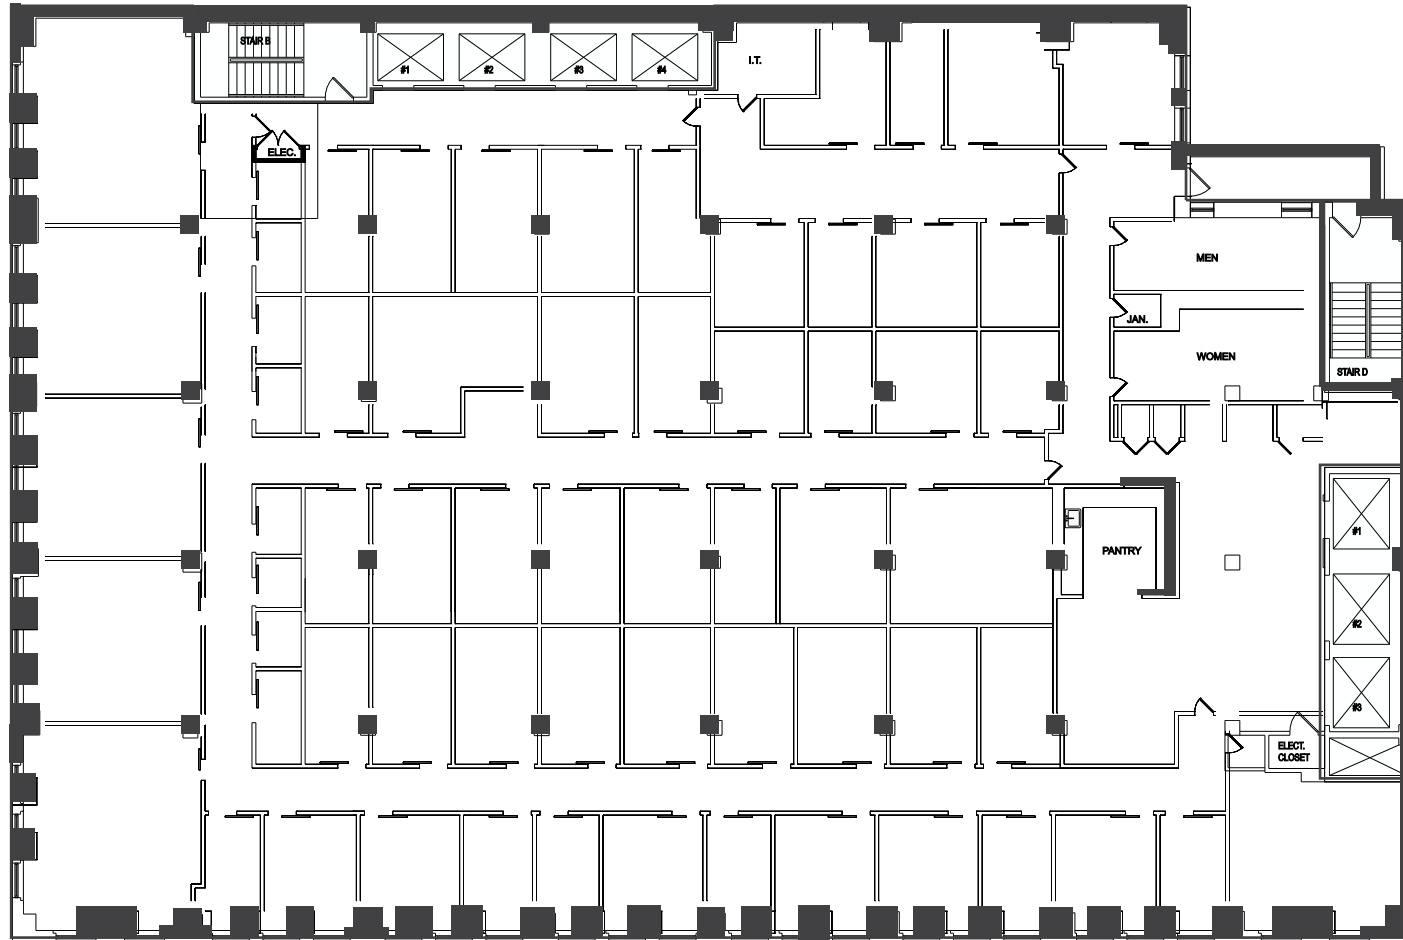


FLOOR 5

18,600 RSF

**75,000 RSF of Contiguous Space Available*

AS-BUILT

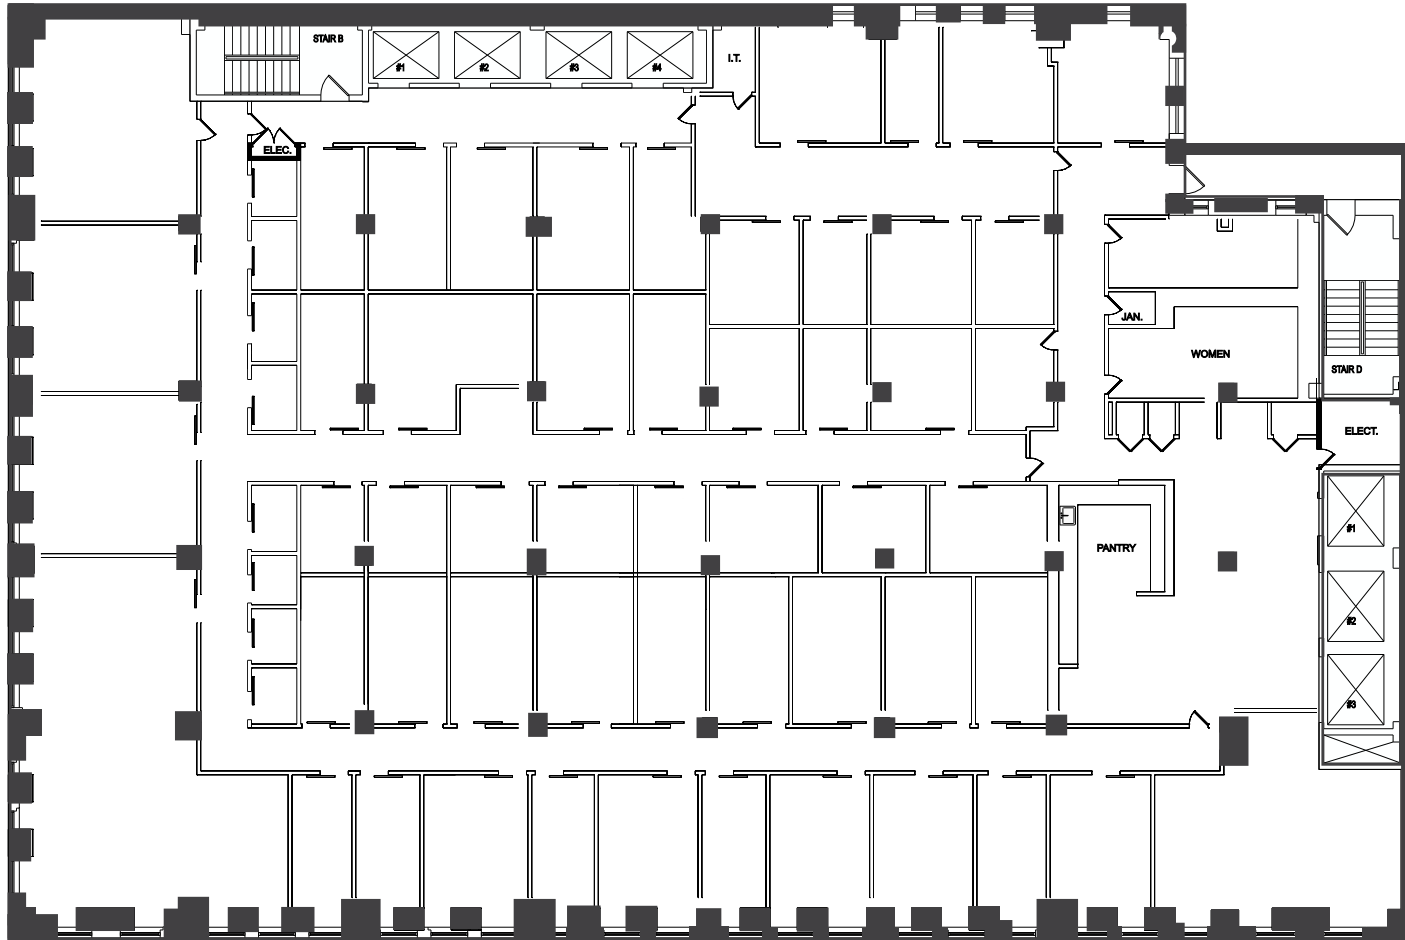


FLOOR 6

18,600 RSF

**75,000 RSF of Contiguous Space Available*

AS-BUILT

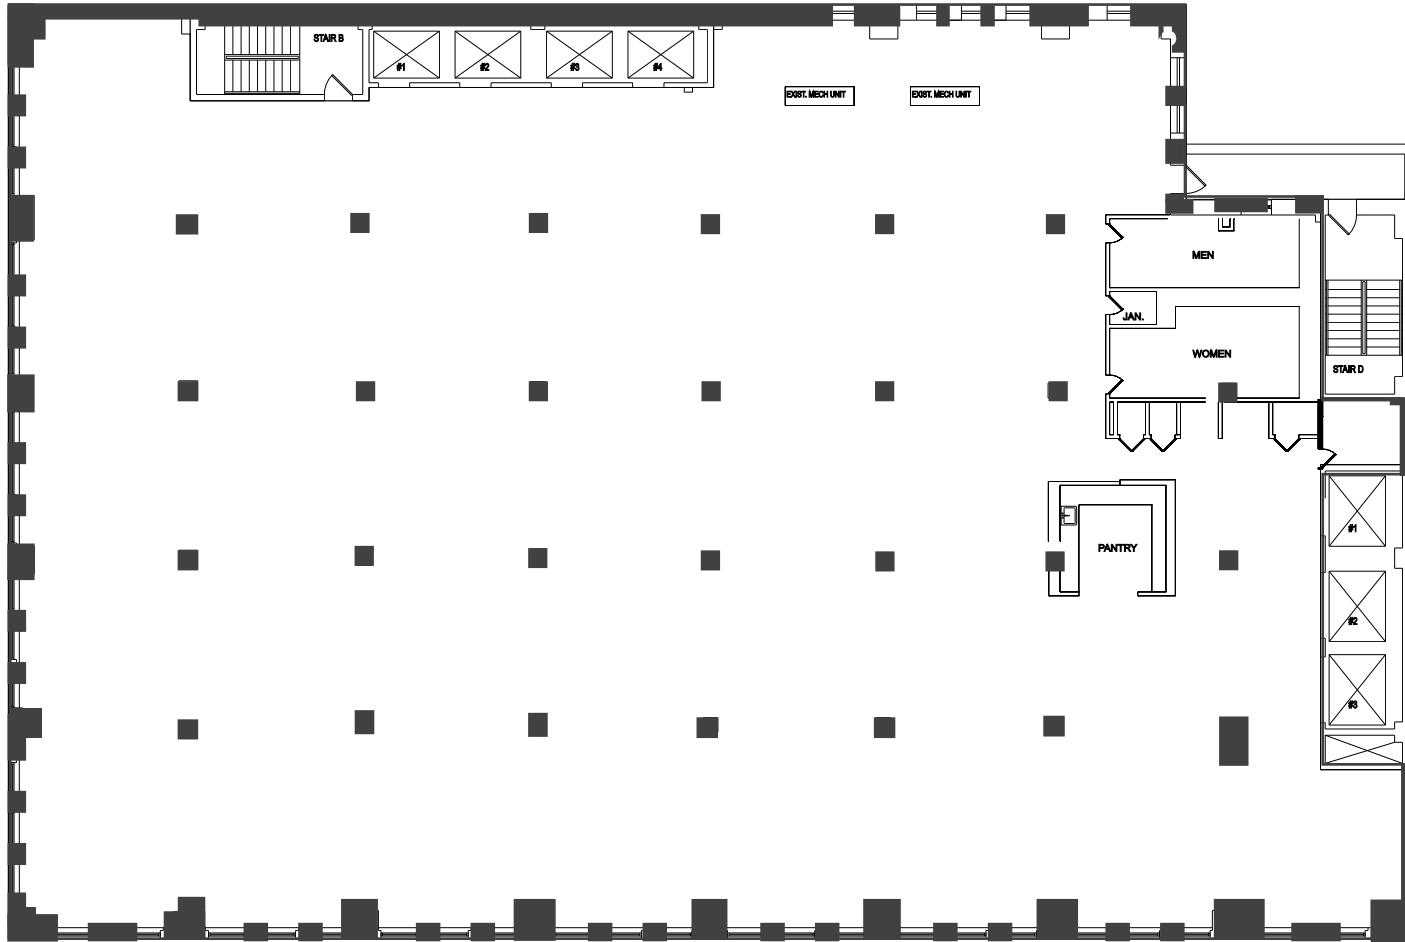


FLOOR 9

18,600 RSF

**75,000 RSF of Contiguous Space Available*

AS-BUILT

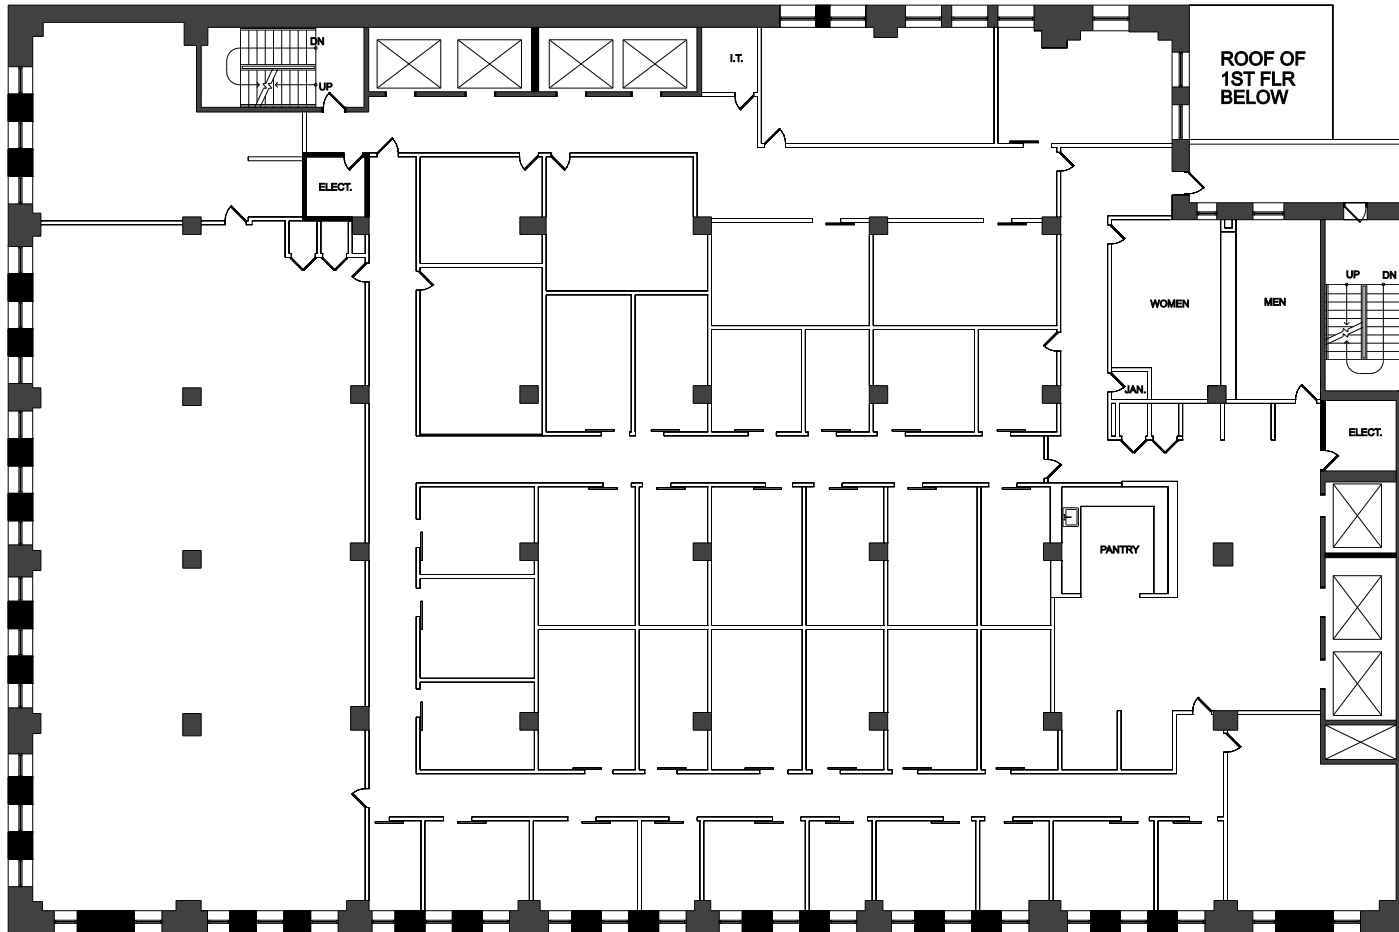


FLOOR 10

18,600 RSF

**75,000 RSF of Contiguous Space Available*

AS-BUILT

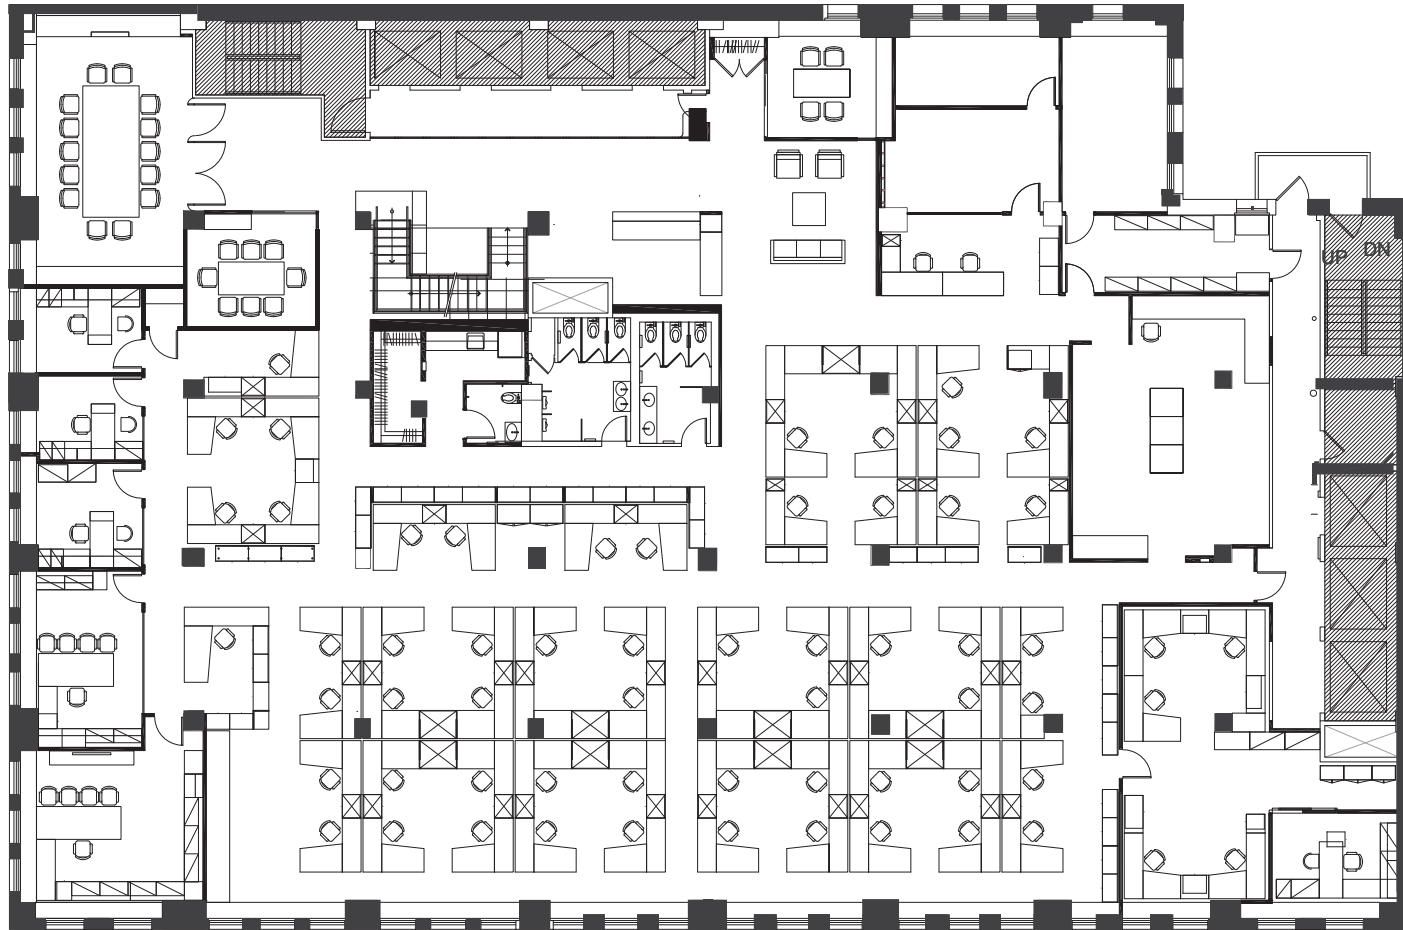


FLOOR 11

18,600 RSF

**75,000 RSF of Contiguous Space Available*

AS-BUILT

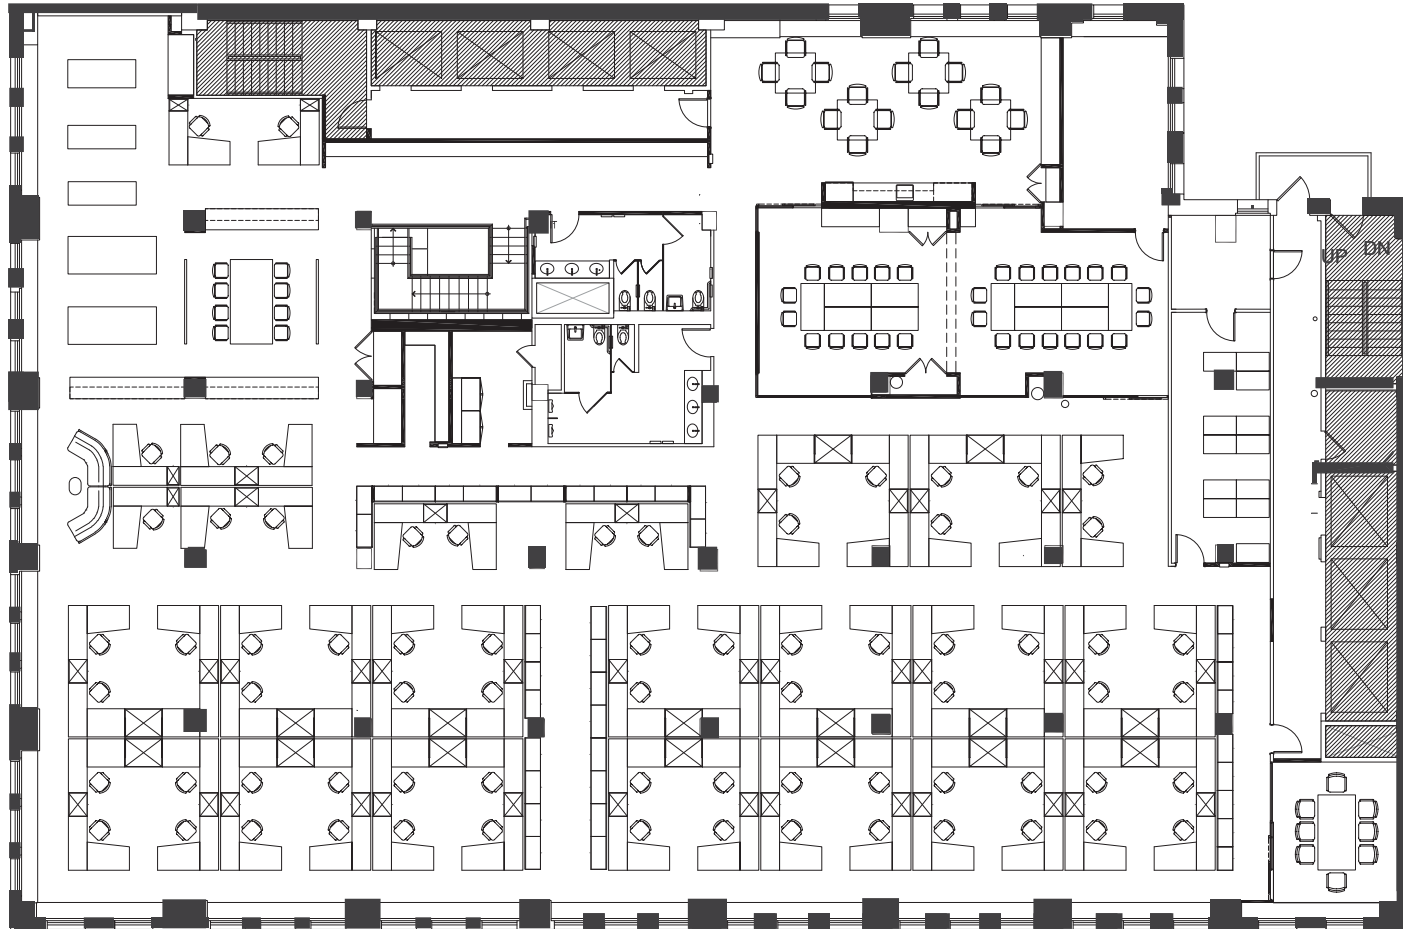


FLOOR 12

18,600 RSF

**75,000 RSF of Contiguous Space Available*

AS-BUILT

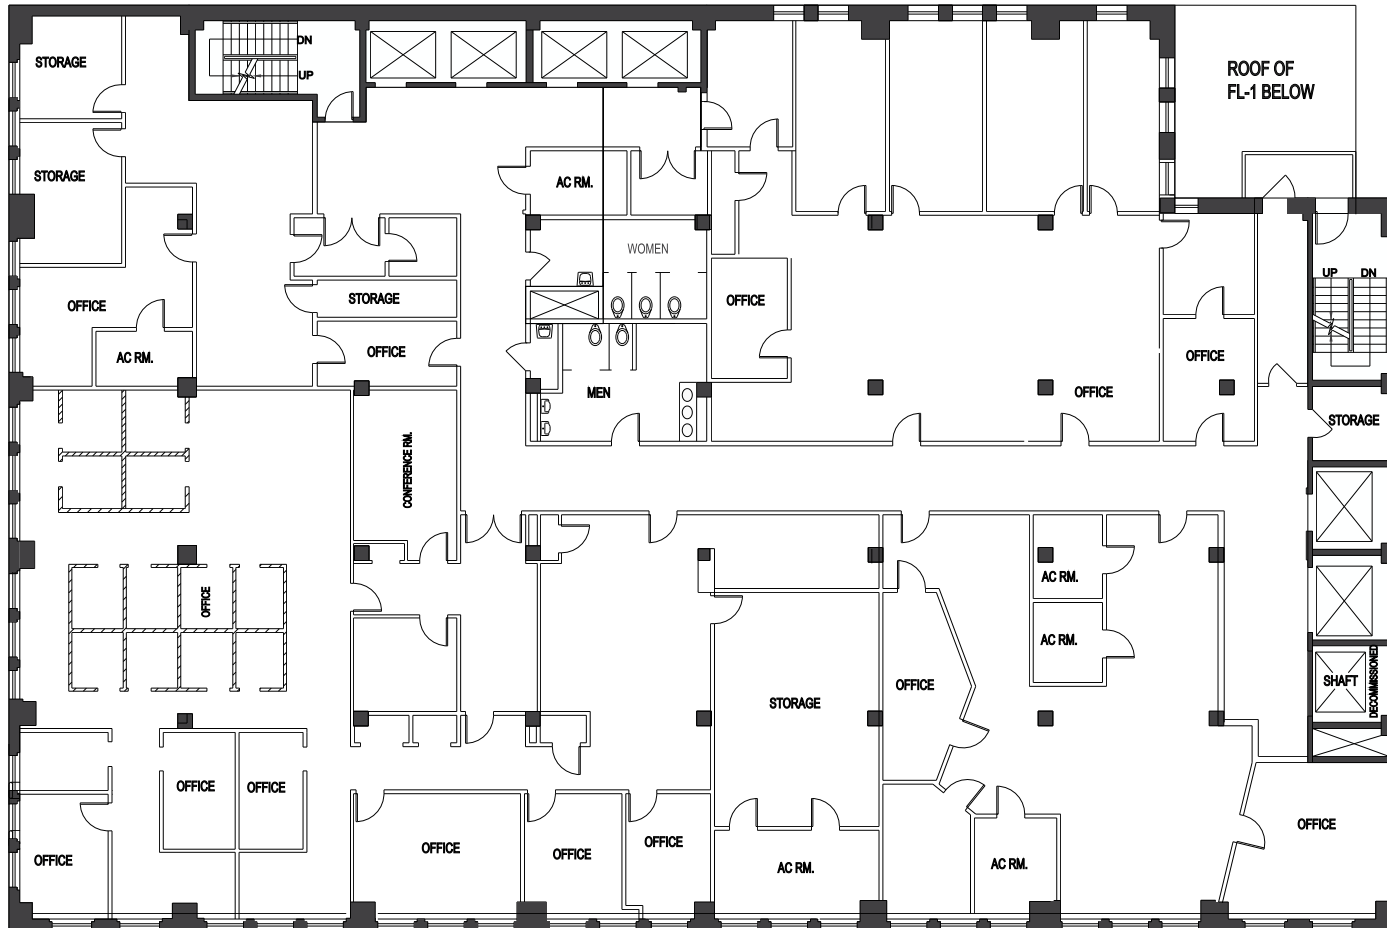

BUILT SPACE

FLOOR 14

PLAN VIEW

