


# FLOOR 5

18,600 RSF

*\*75,000 RSF of Contiguous Space Available*

# AS-BUILT

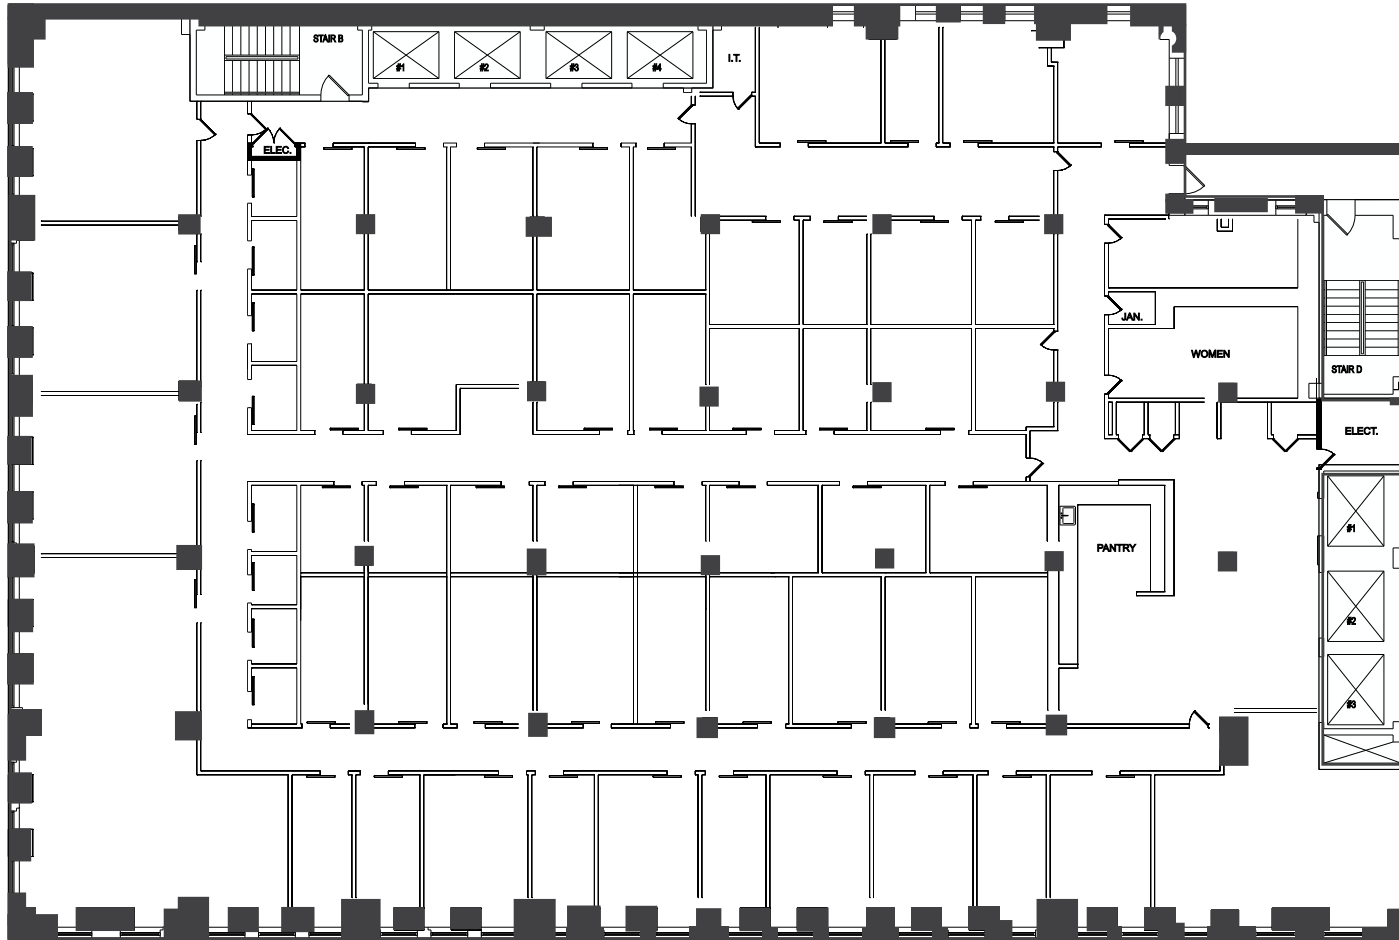

# FLOOR 5

18,600 RSF

*\*75,000 RSF of Contiguous Space Available*

# BUILT SPACE

*Typical Plan*

