


FLOOR 6

18,600 RSF

**75,000 RSF of Contiguous Space Available*

AS-BUILT

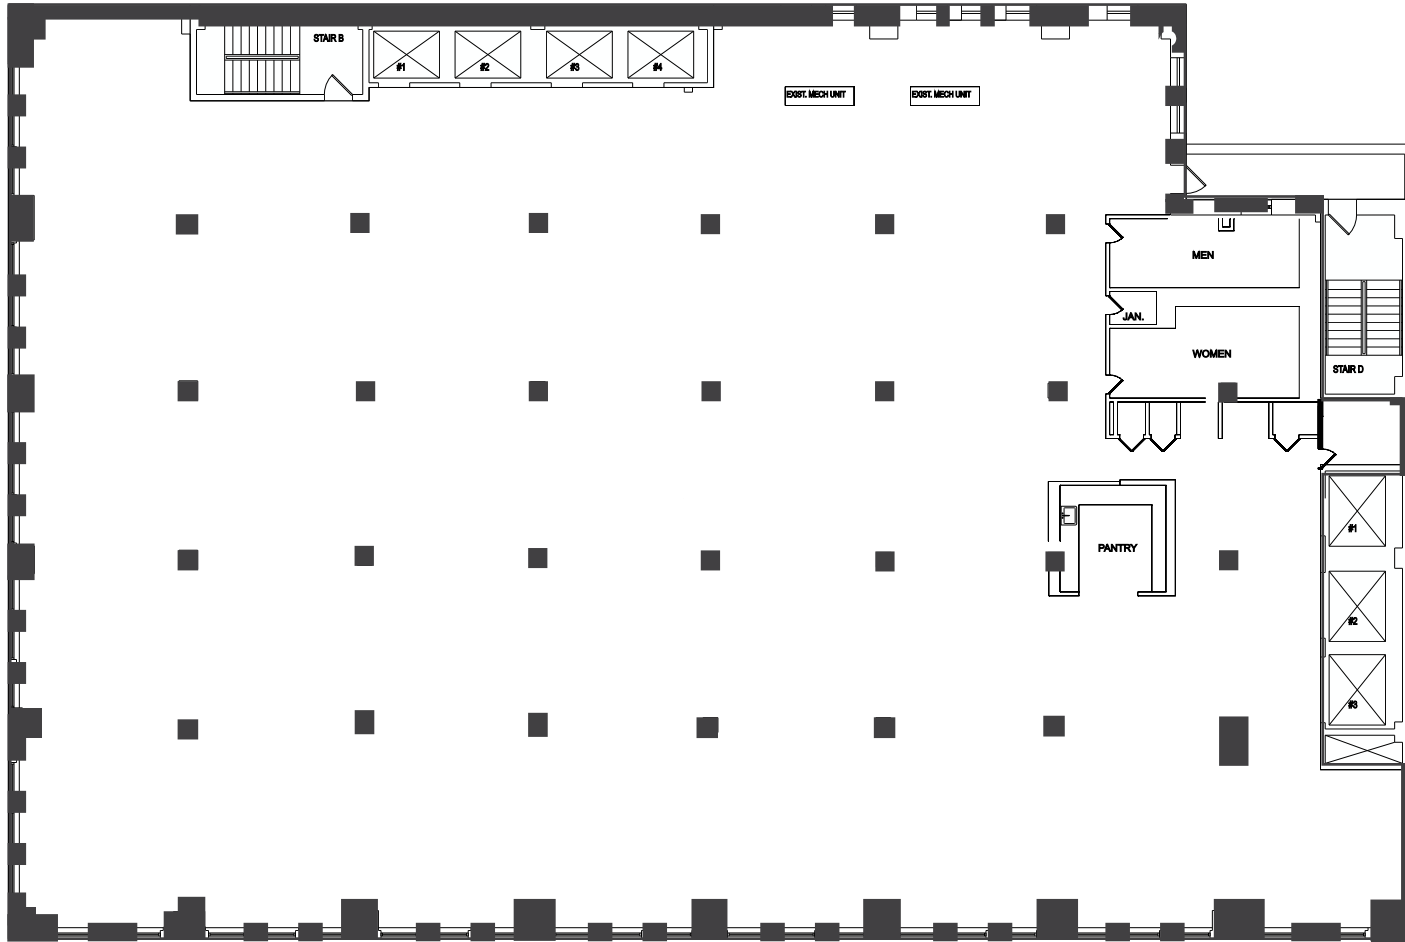

FLOOR 6

18,600 RSF

**75,000 RSF of Contiguous Space Available*

BUILT SPACE

Typical Plan

